



SOUTH MELROSE DRIVE

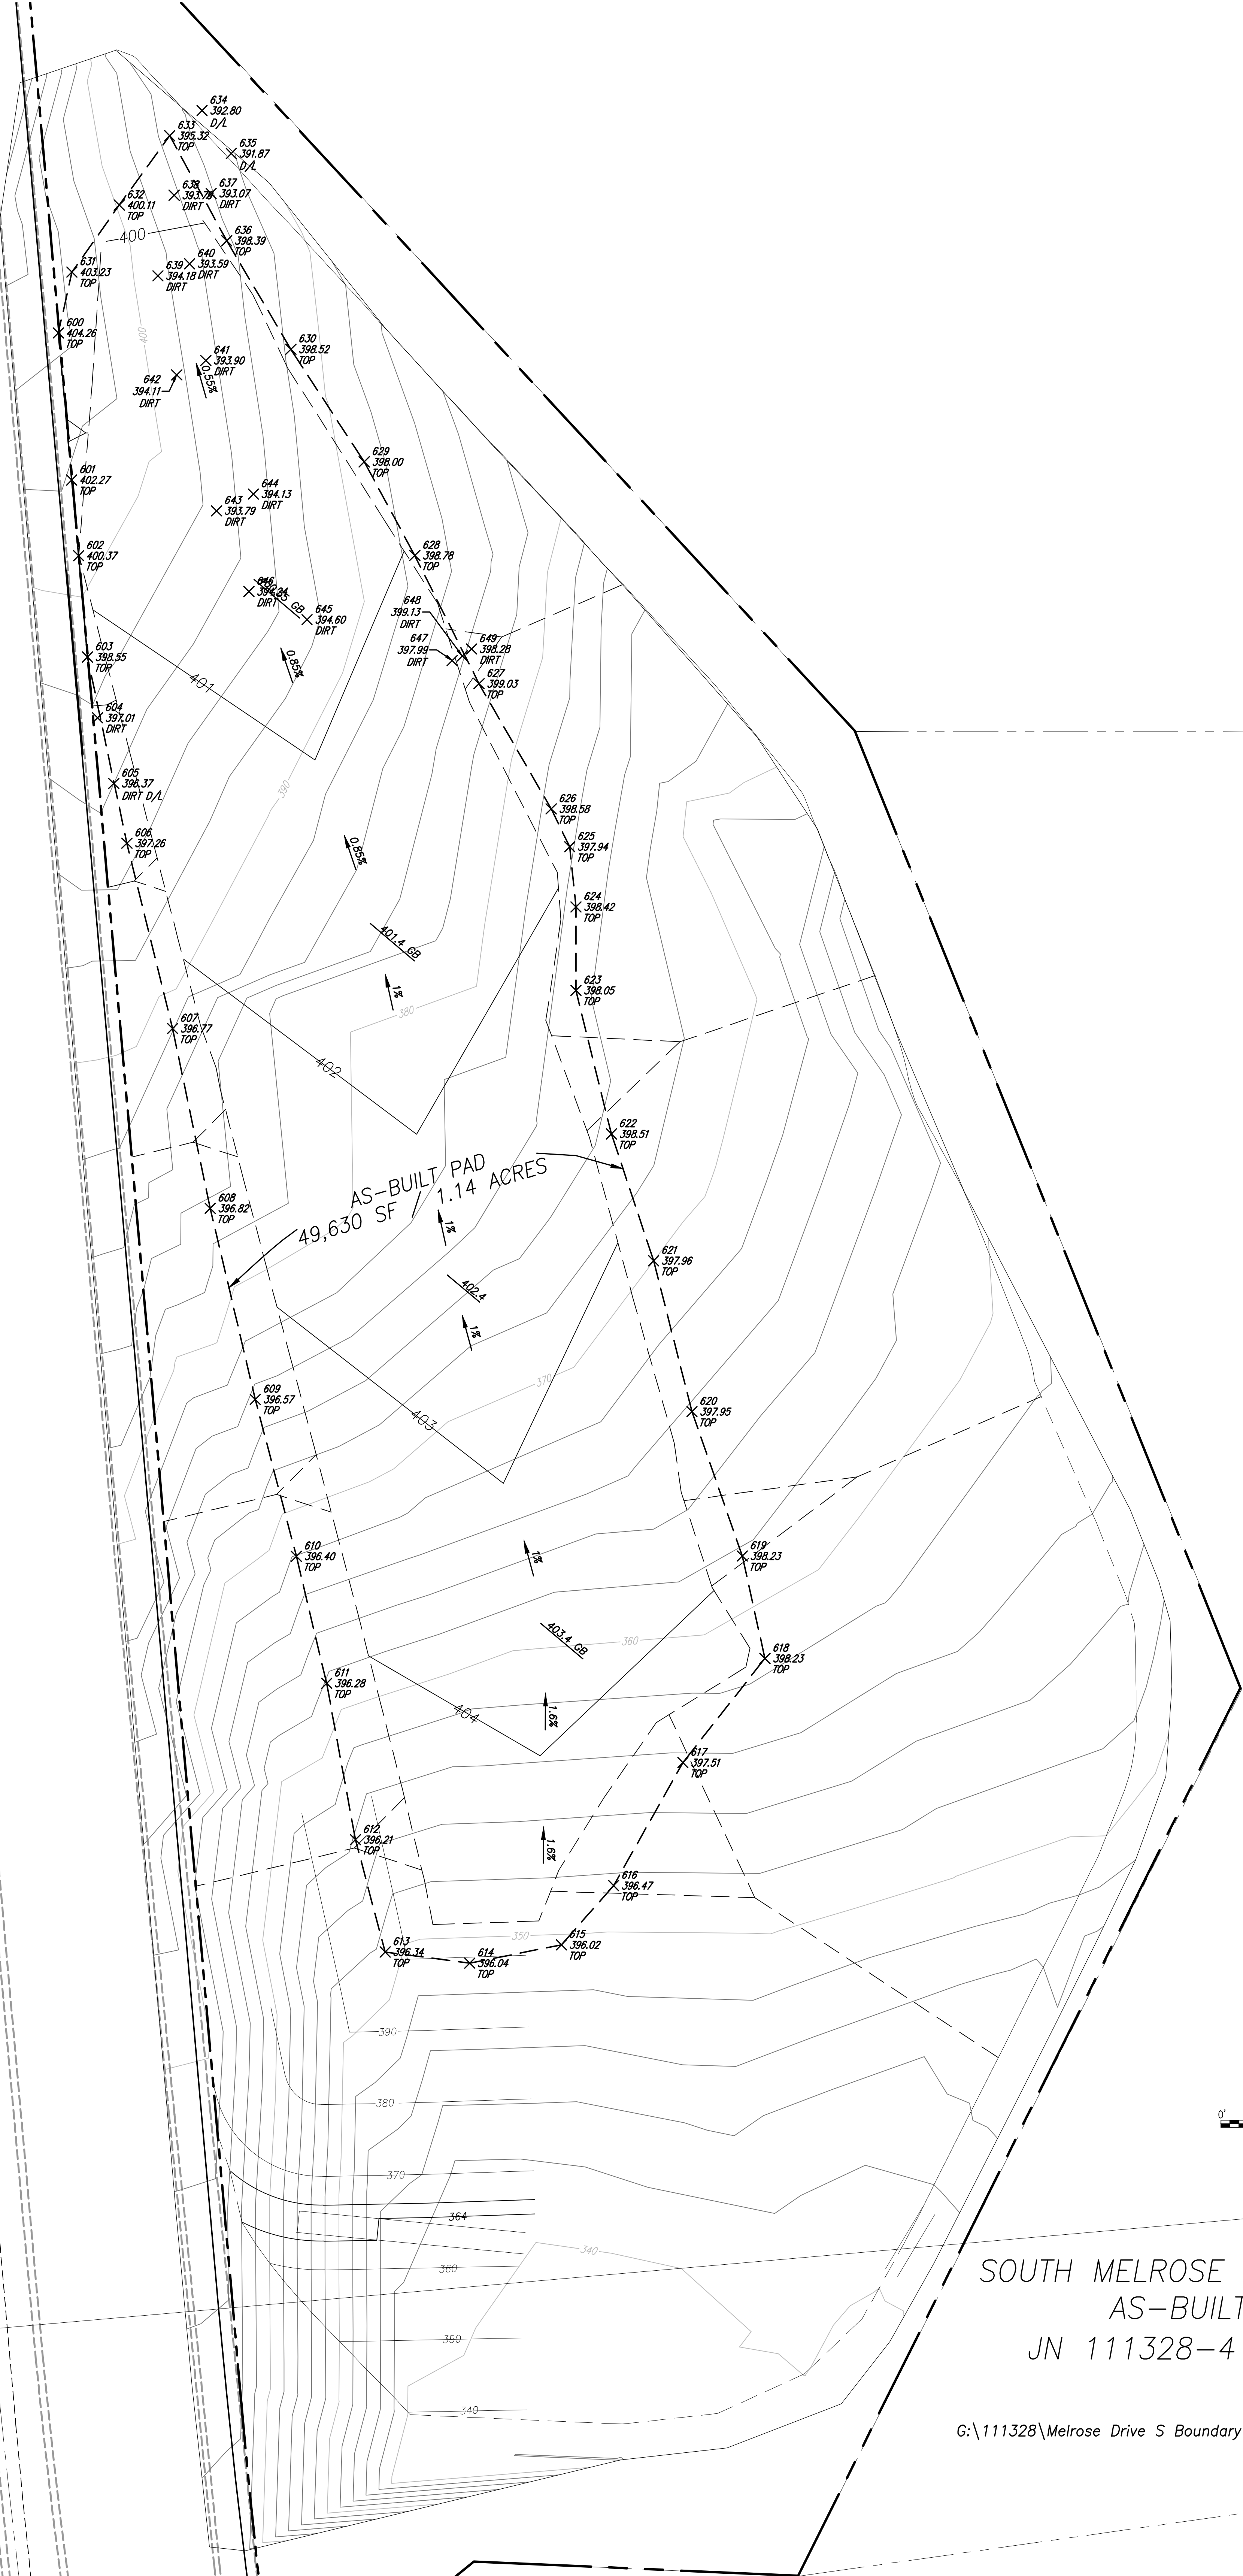

AS-BUILT PAD
1.14 ACRES
49,630 SF

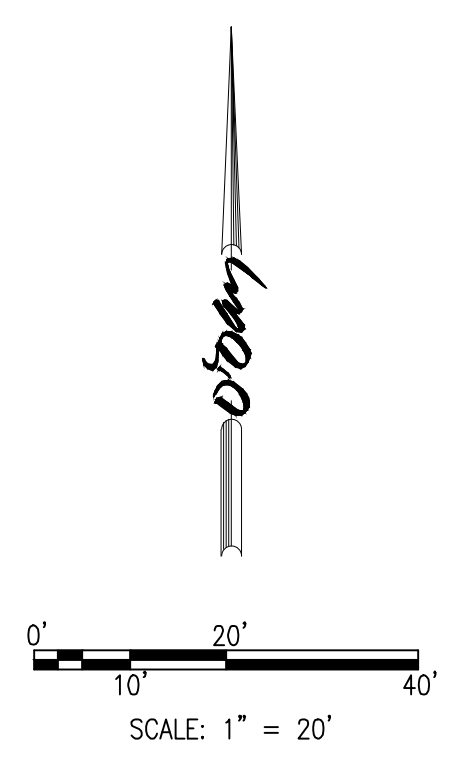

SOUTH MELROSE DRIVE GRADING PLAN
 AS-BUILT PAD TOPO
 JN 111328-4 11/10/14